
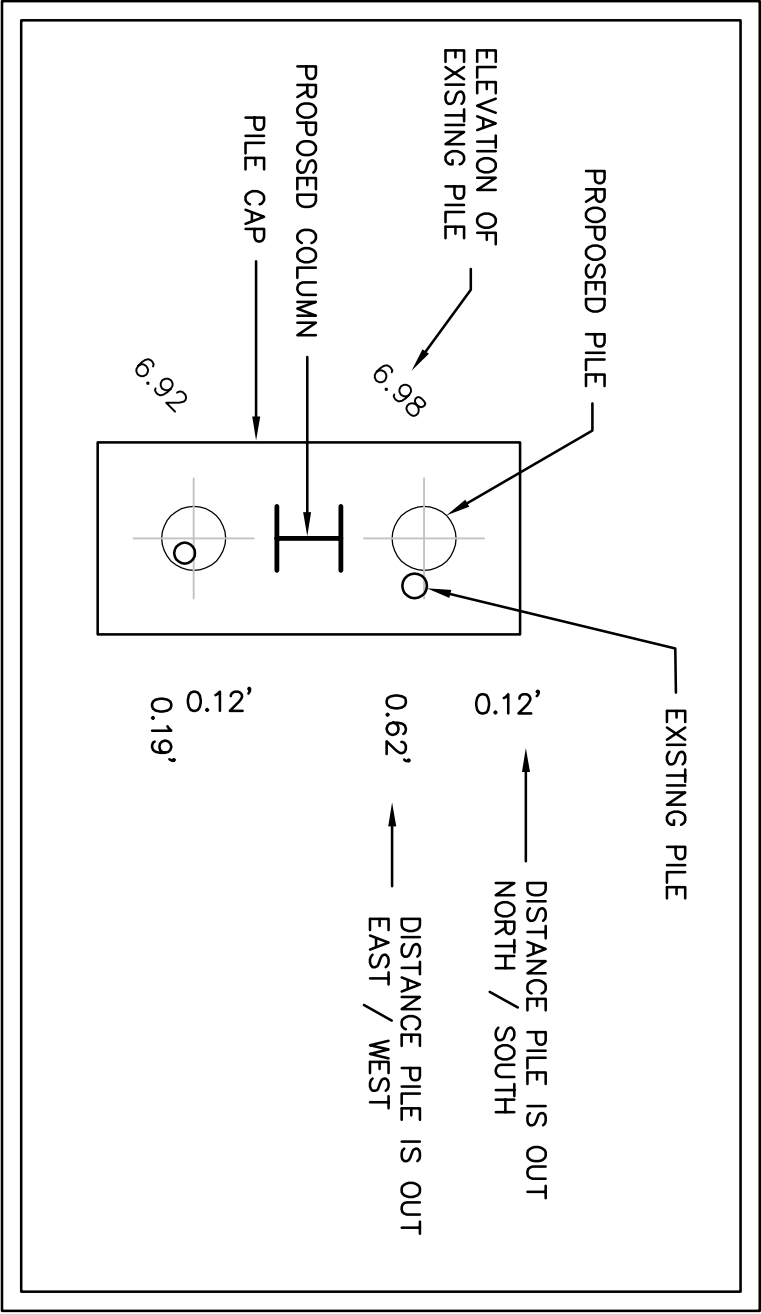
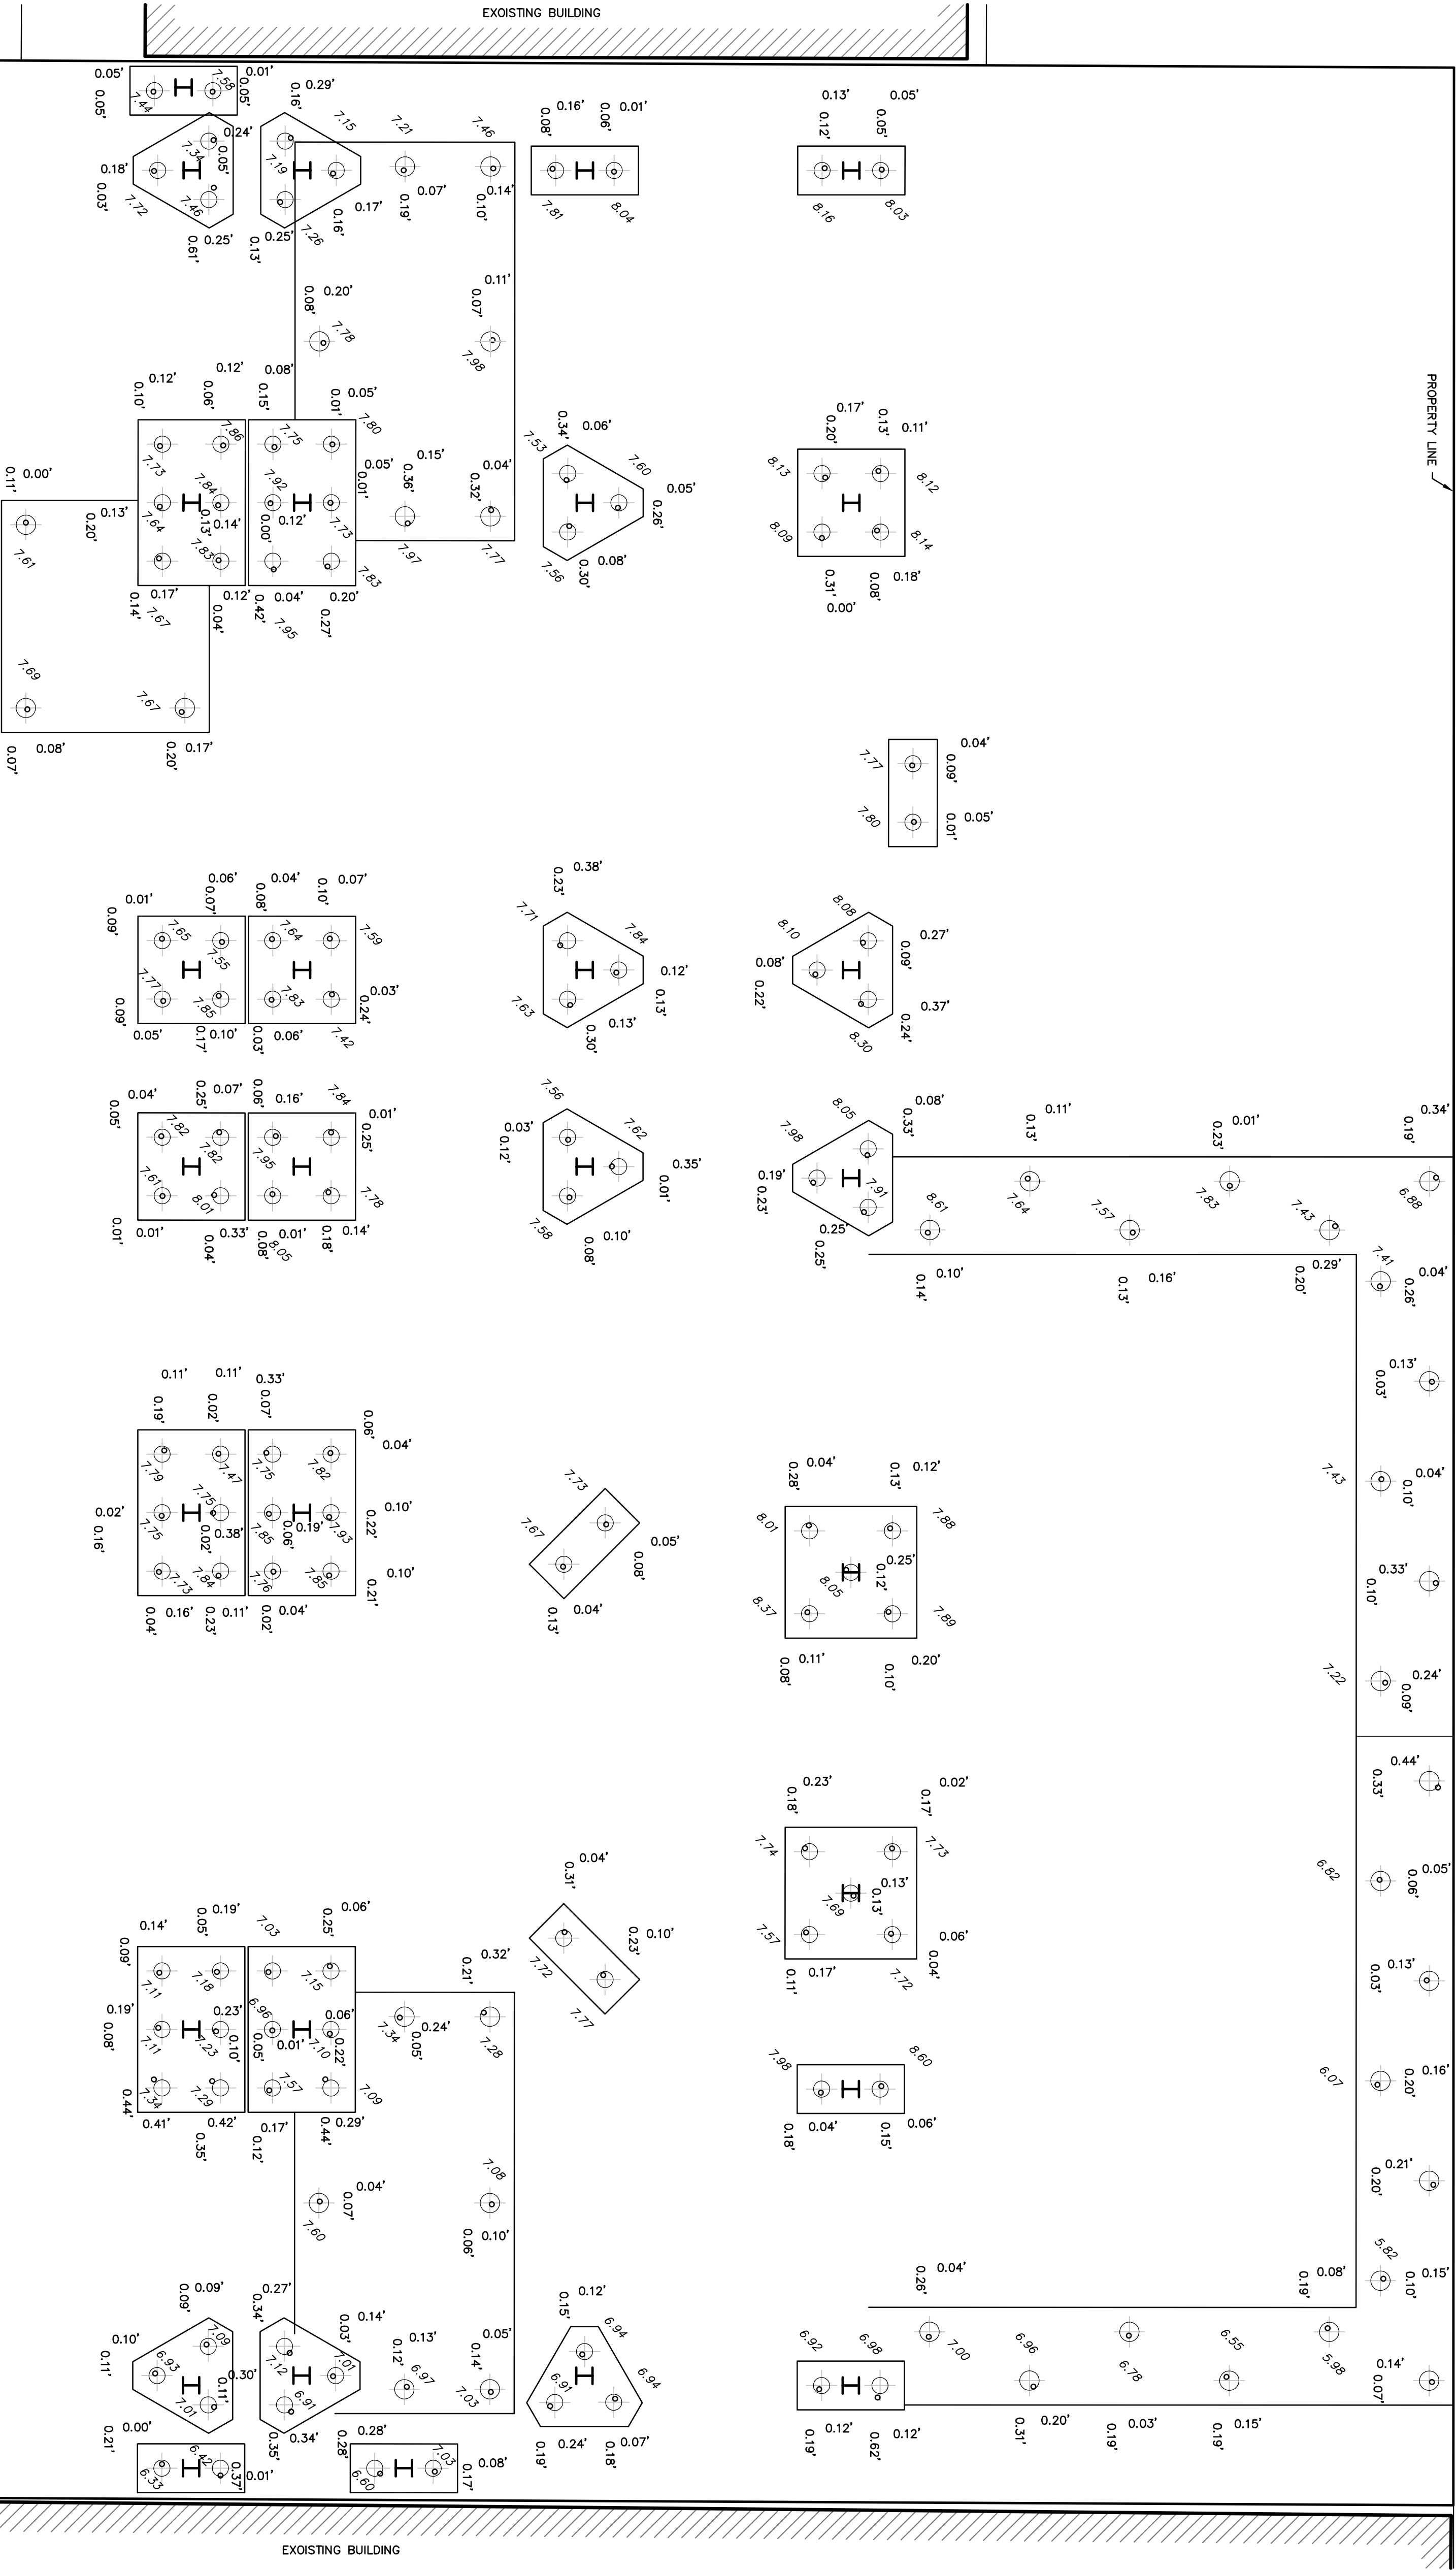


No.	DATE	DESCRIPTION	BY

PILE AS BUILT

28 BRIGHT STREET
LOT 39 IN BLOCK 14108 ON TAX MAPS OF
(FORMERLY LOT 175 IN BLOCK 233)
CITY OF JERSEY CITY HUDSON COUNTY NEW JERSEY
PREPARED FOR

NO CERTIFICATE OF AUTHORIZATION 24648072100	DATE: 9-28-2015
DRAWN BY: M. PRONESTI	SCALE: 1"=5'
CHECKED BY: M. PRONESTI	JOB No. 51311
PROFESSIONAL LAND SURVEYORS	SHEET 1 OF 1

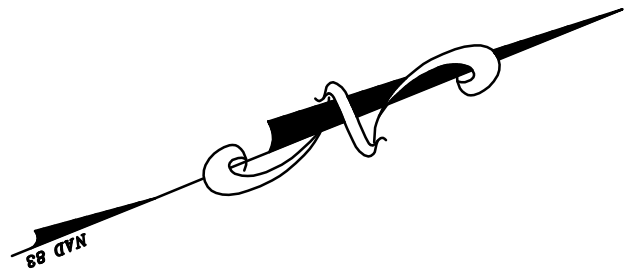

PRONESTI
SURVEYING, INC.
PROFESSIONAL LAND SURVEYORS

870 BOUNTON AVENUE, SUITE B1
CEDAR GROVE, NJ 07009
TEL. (973) 857-3319 • FAX (973) 857-3608
WWW.PRONESTI.COM
MICHAEL PRONESTI, P.L.S.
NJ LIC. No. 37605

BRIGHT STREET

• PRONESTI SURVEYING, INC.